




FOR BINDING

01  
0

AL BARAHA (AREA)  
1/100

Key Plan:

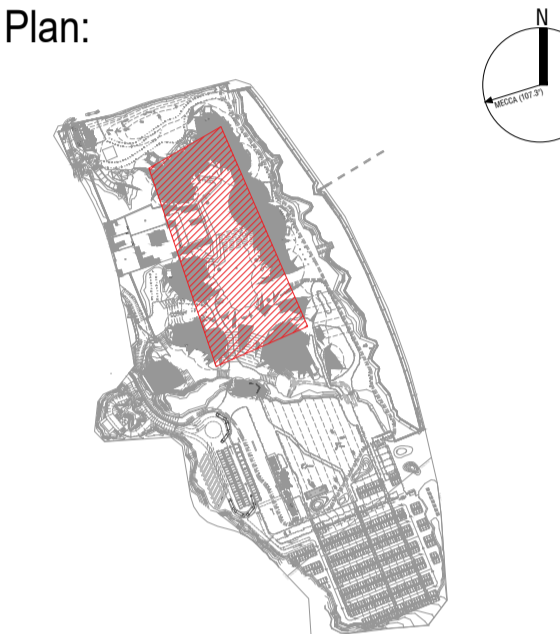

REFERENCE DRAWINGS


<b>AS-BUILT</b>	
REVIEWED BY:	APPROVED BY:
DATE:	DATE:

CLIENT:

**QATAR MUSEUMS AUTHORITY**

هيئة متاحف قطر

Client's Representative / PM:

ARCHITECT:

**Ateliers Jean Nouvel**  
10 CITE D'ANGOULEME 75011 PARIS

MAIN CONTRACTOR:

**National Museum of Qatar**  
AL BARAHA (AREA)

THIS IS A CAD DRAWING AND MUST NOT BE ALTERED MANUALLY

DRAWING SCALE: AS SHOWN    ORIG DWG SIZE: A1

DWG NO: SKETCH	REV.
----------------	------